

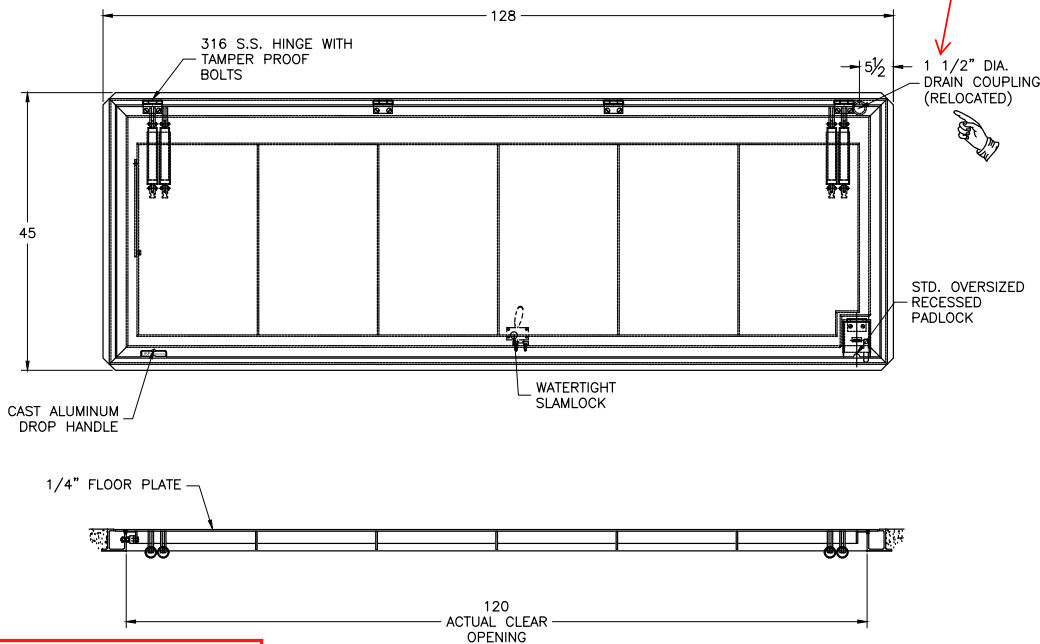


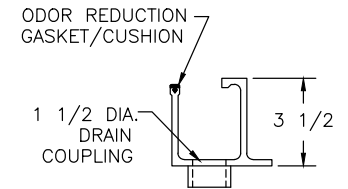

Drain location correct,
typ. for 2 of 4 hatches

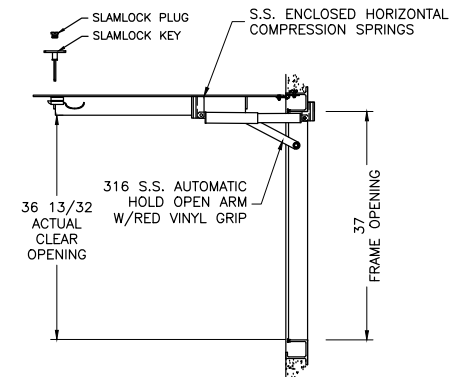

1/4" EXTRUDED TROUGH SECTION W/INTEGRAL CONT. ANCHOR FLANGE & GROOVE FOR GASKET/CUSHION
FRAME MAT'L: ALUMINUM 6063-T5

FRAME DETAIL

- SELECTED FEATURES**
1. ENCLOSED HORIZONTAL SPRINGS
 2. SLAMLOCK
 3. BOLT LOCK
 4. OVERSIZED RECESSED PADLOCK
 5. BITUMINOUS COATING
 6. DRAIN COUPLING RELOCATED FRONT RIGHT

- NOTES**
1. MATERIAL: ALUMINUM
 2. FINISH: MILL
 3. LOADING: 300 PSF
 4. 316 SS NUTS & BOLTS
 5. AREA OF FRAME IN CONTACT WITH CONCRETE TO BE PAINTED WITH BITUMINOUS COATING
 6. APPROX HATCH WT: 278.24 LBS

- ☐ NO EXCEPTIONS TAKEN
- ☒ MAKE CORRECTIONS NOTED
- ☐ REJECTED
- ☐ REVISE AND RESUBMIT
- ☐ SUBMIT SPECIFIED ITEM(S)

Review is only for general conformance with the design concept of the project and general compliance with the requirements of the contract documents. Any action shown is subject to the requirements of the plans and specifications. Contractors responsibilities include, but are not limited to actual dimensions which shall be confirmed and correlated at the job site; preferred fabrication processes and techniques of construction; coordination of the contractor's work with that of all other trades, and the satisfactory performance of the contractor's work.

BDC Architecture Services
Public Works
City and County of San Francisco

12/14/2022 DSabatino/MPierron
Date By

1	11-29-22	C.R.	C.R.	RELOCATED DRAIN LOCATION BACK RIGHT
REV.	DATE	BY	CHK.	DESCRIPTION
				UNLESS OTHERWISE NOTED ON THIS DRAWING, CLEARANCE BETWEEN FRAME AND COVER(S) IS DESIGNED NOT TO EXCEED 3/8".
				THIS DOCUMENT IS THE PROPERTY OF U.S.F. FABRICATION, INC AND CONTAINS PROPRIETARY INFORMATION. IT SHALL NOT BE MODIFIED, COPIED, FURNISHED NOR DISTRIBUTED (IN WHOLE OR IN PART) WITHOUT PROPER AUTHORIZATION OF U.S.F. FABRICATION, INC.

INTERPRET DIMENSIONS AND TOLERANCES PER ASME Y14.5M

BREAK ALL SHARP CORNERS & EDGES TO 0.01

TOLERANCES UNLESS OTHERWISE SPECIFIED FRACTIONAL

<10' = ± 1/8
>10' = ± 1/4

COPYRIGHT © 2020
ALL RIGHTS RESERVED



U.S.F. FABRICATION INC.
HIALEAH, FLORIDA

HATCH TPS 37 X 120 ALUM

DWN. BY: BOB	SCALE: 1:20	SHEET: 1 OF 1	DATE: 09/12/22
CHK. BY: C.R.	DWG.# 1000212891	SHEET SIZE: B	REV: 1