
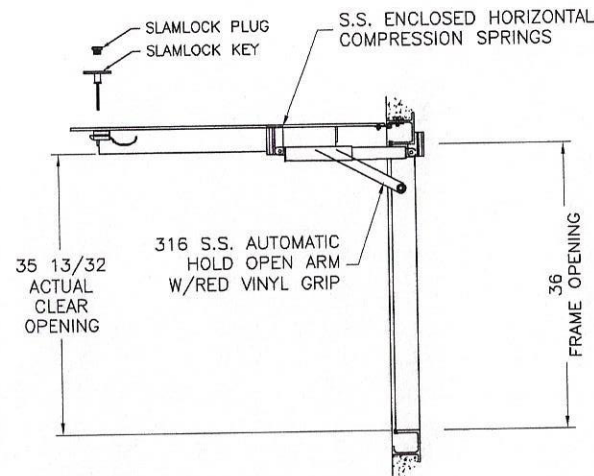


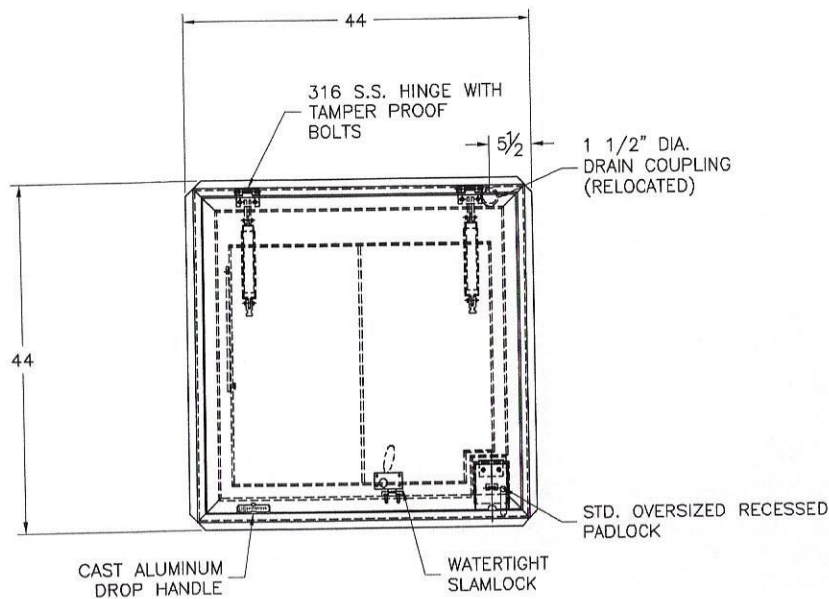


SELECTED FEATURES

1. ENCLOSED HORIZONTAL SPRINGS
2. SLAMLOCK
3. OVERSIZED RECESSED PADLOCK
4. BITUMINOUS COATING

NOTES

1. MATERIAL: ALUMINUM
2. FINISH: MILL
3. LOADING: 300 PSF
4. 316 SS NUTS & BOLTS
5. AREA OF FRAME IN CONTACT WITH CONCRETE TO BE PAINTED WITH BITUMINOUS COATING
6. APPROX HATCH WT: 115.97 LBS

ODOR REDUCTION GASKET/CUSHION

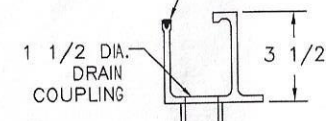

1/4" EXTRUDED TROUGH SECTION W/INTEGRAL CONT. ANCHOR FLANGE & GROOVE FOR GASKET/CUSHION
FRAME MAT'L: ALUMINUM 6063-T5

FRAME DETAIL

1/4" FLOOR PLATE


- ☒ NO EXCEPTIONS TAKEN
- ☐ MAKE CORRECTIONS NOTED
- ☐ REJECTED
- ☐ REVISE AND RESUBMIT
- ☐ SUBMIT SPECIFIED ITEM(S)

Review is only for general conformance with the design concept of the project and general compliance with the requirements of the contract documents. Any action shown is subject to the requirements of the plans and specifications. Contractors responsibilities include, but are not limited to actual dimensions which shall be confirmed and correlated at the job site; preferred fabrication processes and techniques of construction; coordination of the contractor's work with that of all other trades, and the satisfactory performance of the contractor's work.

BDC Architecture Services
Public Works
City and County of San Francisco

12/14/2022 DSabatino/MPierron

Date _____ By _____

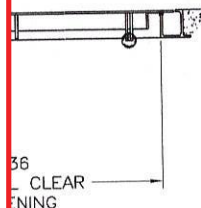

THIS DOCUMENT IS THE PROPERTY OF U.S.F. FABRICATION, INC AND CONTAINS PROPRIETARY INFORMATION. IT SHALL NOT BE MODIFIED, COPIED, FURNISHED NOR DISTRIBUTED (IN WHOLE OR IN PART) WITHOUT PROPER AUTHORIZATION OF U.S.F. FABRICATION, INC.

INTERPRET DIMENSIONS AND TOLERANCES PER ASME Y14.5M
BREAK ALL SHARP CORNERS & EDGES TO 0.01

TOLERANCES UNLESS OTHERWISE SPECIFIED FRACTIONAL

INCHES = $\pm 1/16$
1/16 = $\pm 1/32$
1/32 = $\pm 1/64$

COPYRIGHT © 2017
ALL RIGHTS RESERVED



U.S.F. FABRICATION INC.
HIALEAH, FLORIDA

HATCH TPS 36 X 36 ALUM

OWN. BY: BOB	SCALE: 1:16	SHEET: 1 OF 1	DATE: 10/21/19
CHK. BY: LE	DWG.# 1000138207	SHEET SIZE: B	REV: 0